


Traffic Lane Requirements  
Number and Width of Lanes

STREET	TIME	NORTHBOUND	SOUTHBOUND	EASTBOUND	WESTBOUND
GRINDING, PAVING, CONCRETE STREET, & BASE REPAIR WORK					
STONEMAN STREET					
Shotwell St to Bonview St	8AM – 4PM (M-F) Concrete Curing At Other Times	-	-	Closed Closed Full Rdwy	Closed Closed Full Rdwy
Cross Streets for Stoneman St					
Shotwell St (north of Stoneman St)	8AM – 4PM (M-F) At Other Times	1@10' % Full Rdwy	-	-	-
Shotwell St (south of Stoneman St)	8AM – 4PM (M-F) At Other Times	Closed Full Rdwy	Closed Full Rdwy	-	-
Bonview St	At All Times	Full Rdwy	Full Rdwy	-	-

- © The Contractor may close this road to through traffic only during work hours. "Road Closed" signs shall be removed or covered during non-working hours. The Contractor shall set up detour signs in accordance with the approved traffic detour plans as deemed necessary. Local access must be maintained at all times.
- % The Contractor shall have one lane open at the specified width in one direction during the actual construction of the concrete street. The direction of this particular lane will depend on the side of the street that is not being reconstructed at that particular time. For example, if the south side of the street is under construction, then the north side of the street shall be open to one-way traffic westbound. The Contractor may only work on one-half of the street at any one time. The Contractor shall set up and maintain the detour and construction signs according to the approved Traffic Detour Plans as deemed necessary. The Detour Plans for these blocks must include a detour route for SFMTA buses. See Subsection 3.3 MASS TRANSIT VEHICLES for more information.

WORKING AND NON-WORKING HOURS  
SITE DETAIL  
(SEE TCP 065 FOR DETOUR ROUTE)

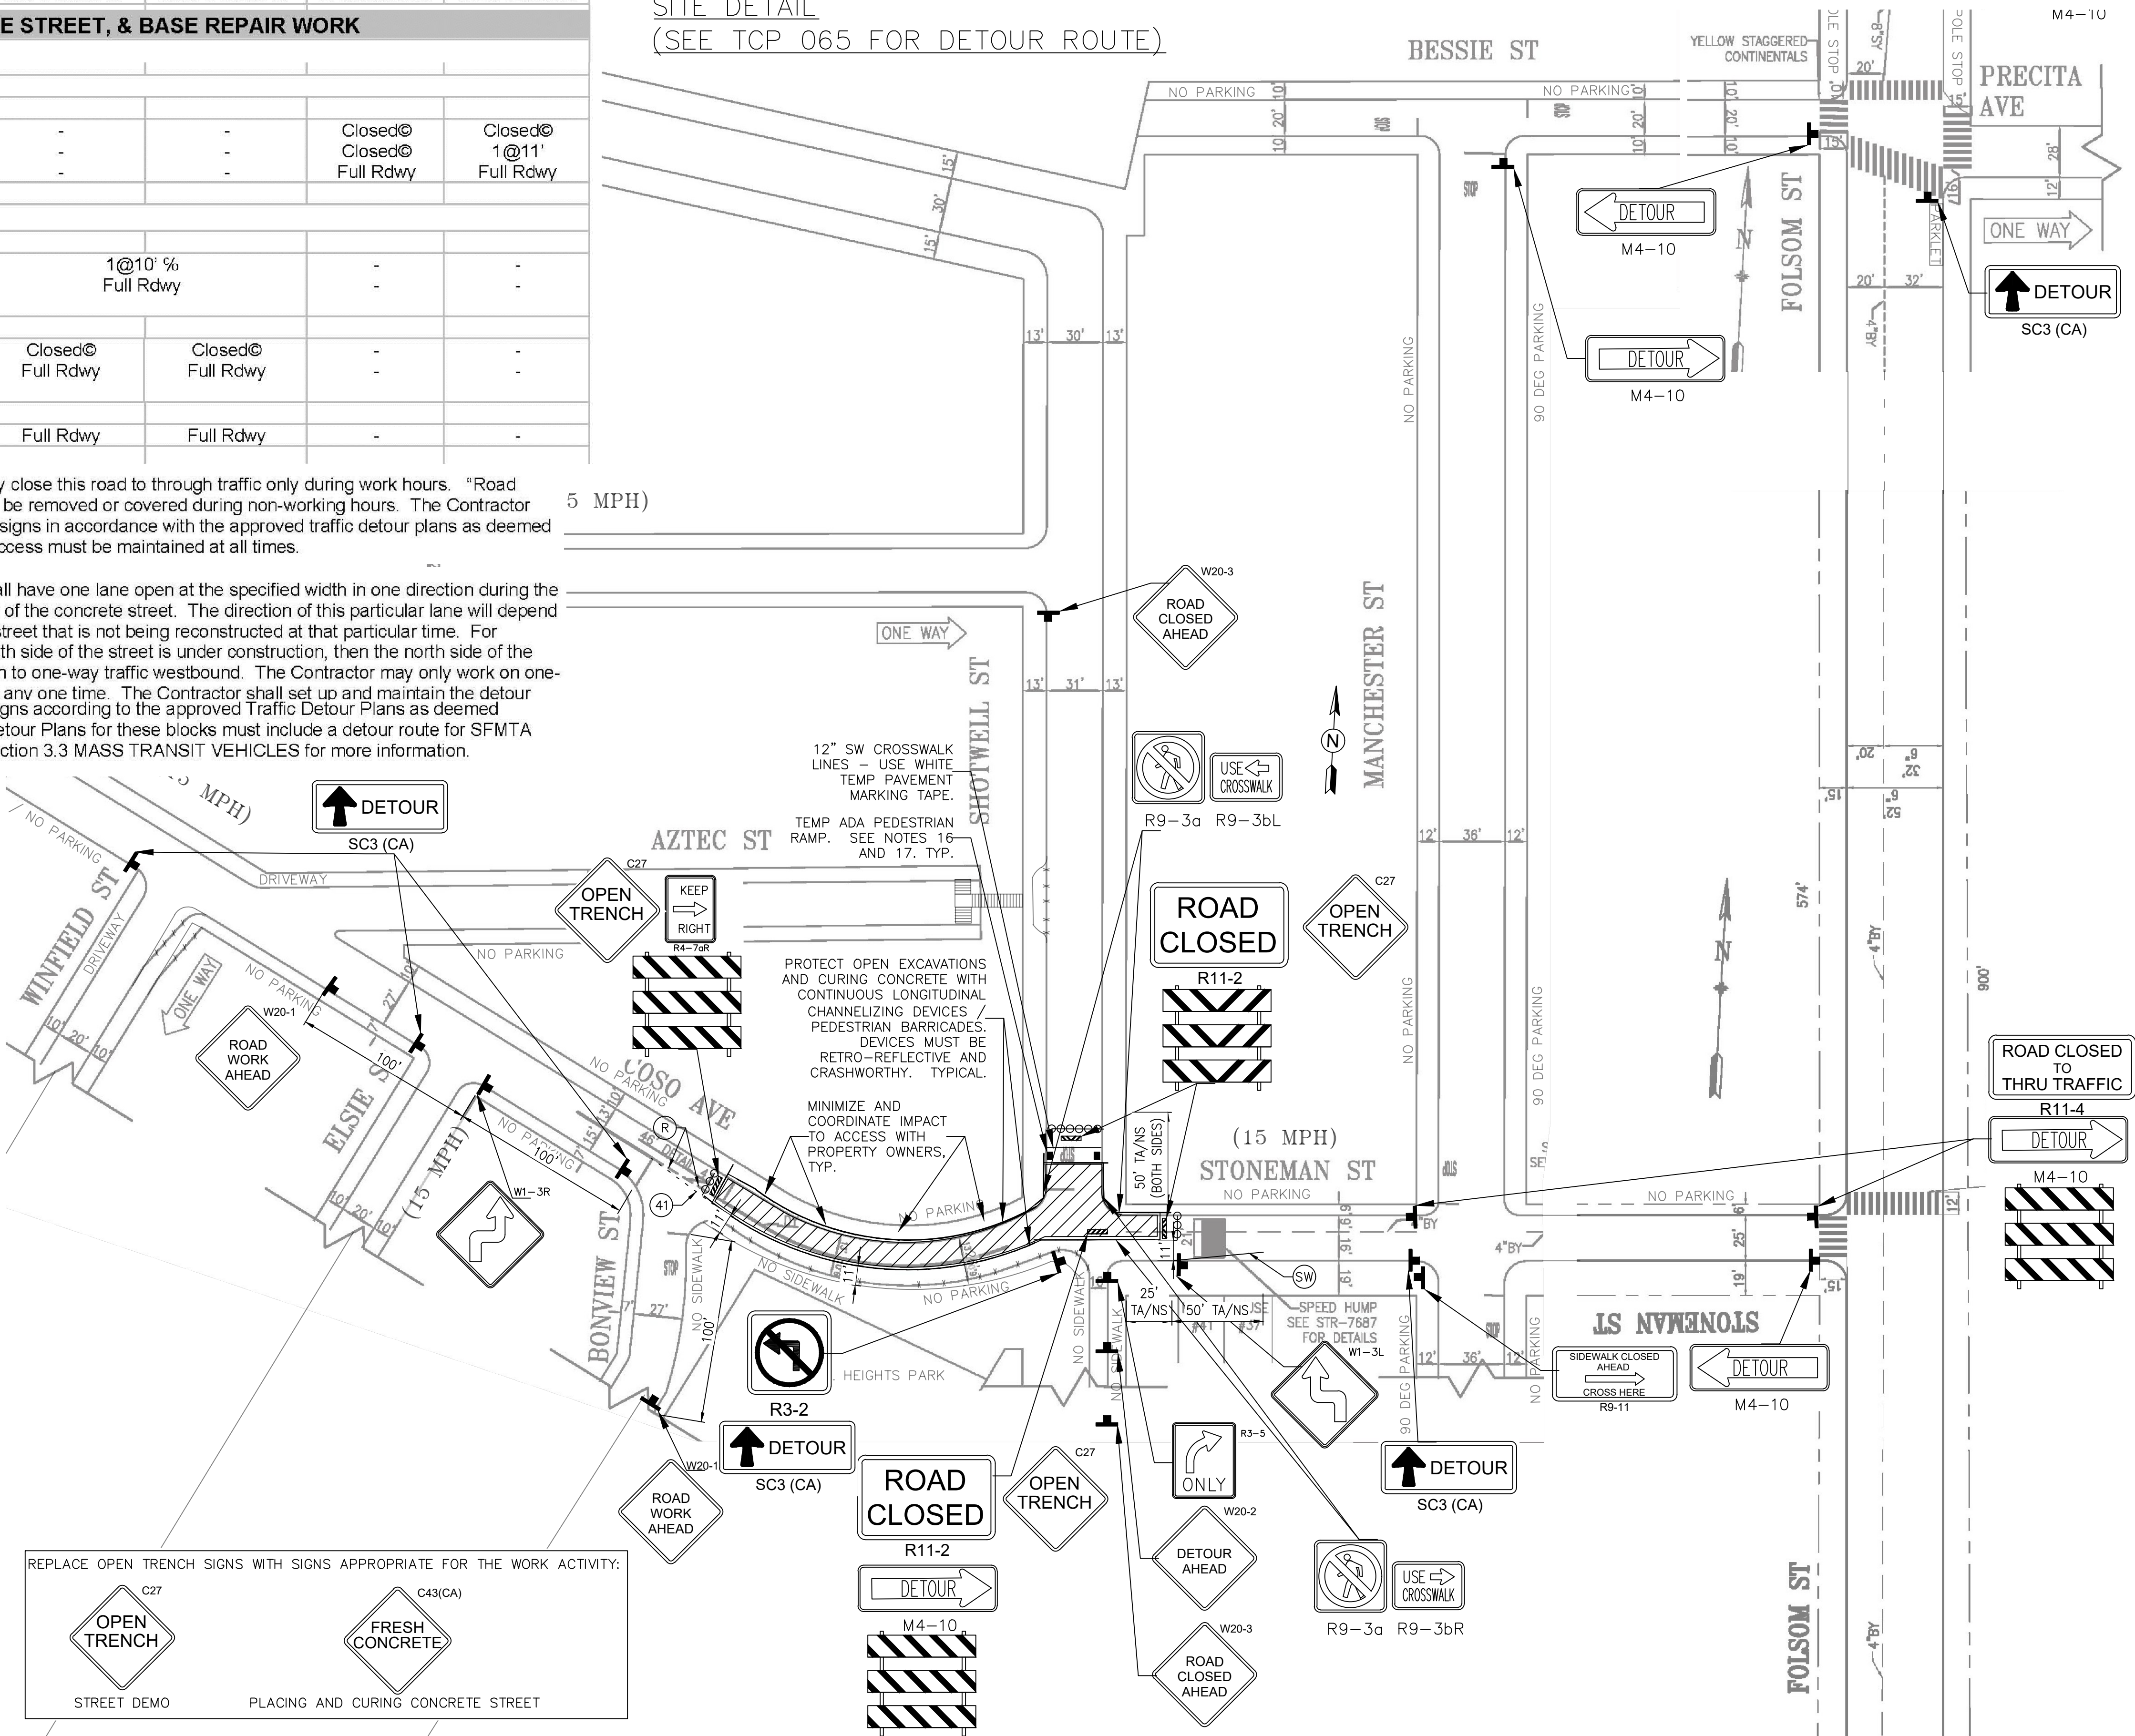

NO EXCEPTIONS TAKEN

MAKE CORRECTIONS NOTED

REJECTED

REVISE AND RESUBMIT

SUBMIT SPECIFIED ITEM(S)

Review is only for general conformance with the design concept of the project and general compliance with the requirements of the contract documents. Any action shown is subject to the requirements of the plans and specifications. Contractor's responsibilities include, but are not limited to, actual dimensions which shall be confirmed and correlated at the job site; preferred fabrication processes and techniques of construction; coordination of the contractor's work with that of all other trades; and the satisfactory performance of the contractor's work.

Sustainable Streets Division  
San Francisco Municipal Transportation Agency  
City and County of San Francisco

By: *[Signature]* Date: 7/6/22

IF THIS SHEET IS NOT 24"x36" , IT IS  
A REDUCED PRINT – SCALE ACCORDINGLY

050100150

1" = 50'

GRAPHIC SCALE

Revisions				
No.	Revisions	By	Date	Appr.

BAY-CON

INFRASTRUCTURE

BAY-CON INFRASTRUCTURE

PO BOX 1342

SAN MATEO CA 94401

(415) 580-1441 OFFICE

(415) 329-3240 FAX

INFO@BAY-CON.COM

Key Plan

This document is the property of the engineer and is not to be used without engineer's written permission. Satellite imagery provided by Google Earth.

Engineer Of Record:  
PHIL MIESZKOWSKI, PE

PHILIP M. MIESZKOWSKI

C 76788

EXP. 12/31/2022

CIVIL

STATE OF CALIFORNIA

5/20/2022

DESIGN DOCUMENTS  
TEMPORARY TRAFFIC CONTROL

Client  
MICHAEL O'SHAUGHNESSY CONSTRUCTION, INC  
48 RIVINGTON DR  
SAN FRANCISCO, CA 94132  
(415) 726-3052  
OFFICE@MOSCONSTRUCTION.ORG  
Owner  
SAN FRANCISCO PUBLIC WORKS  
49 S VAN NESS AVE, SUITE 1600  
SAN FRANCISCO, CA 94103  
(628) 271-3139  
CONTRACTADMIN.STAFF@SFPW.ORG  
Project  
VARIOUS LOCATIONS NO. 52 PAVEMENT  
RENOVATION AND SEWER REPLACEMENT  
SAN FRANCISCO, CA  
SOURCING ID NO. 000003758

Sheet Title  
TCP FOR CONCRETE STREET  
RECONSTRUCTION ON STONEMAN ST FROM  
BONVIEW ST TO SHOTWELL ST – NORTH  
SIDE – WORKING AND NON-WORKING HOURS  
– SHEET 22 OF 46

BQ Job 146	Sheet
Drwn By PM	
Chckd By PM	
Issue Date 05/20/2022	TCP-064